

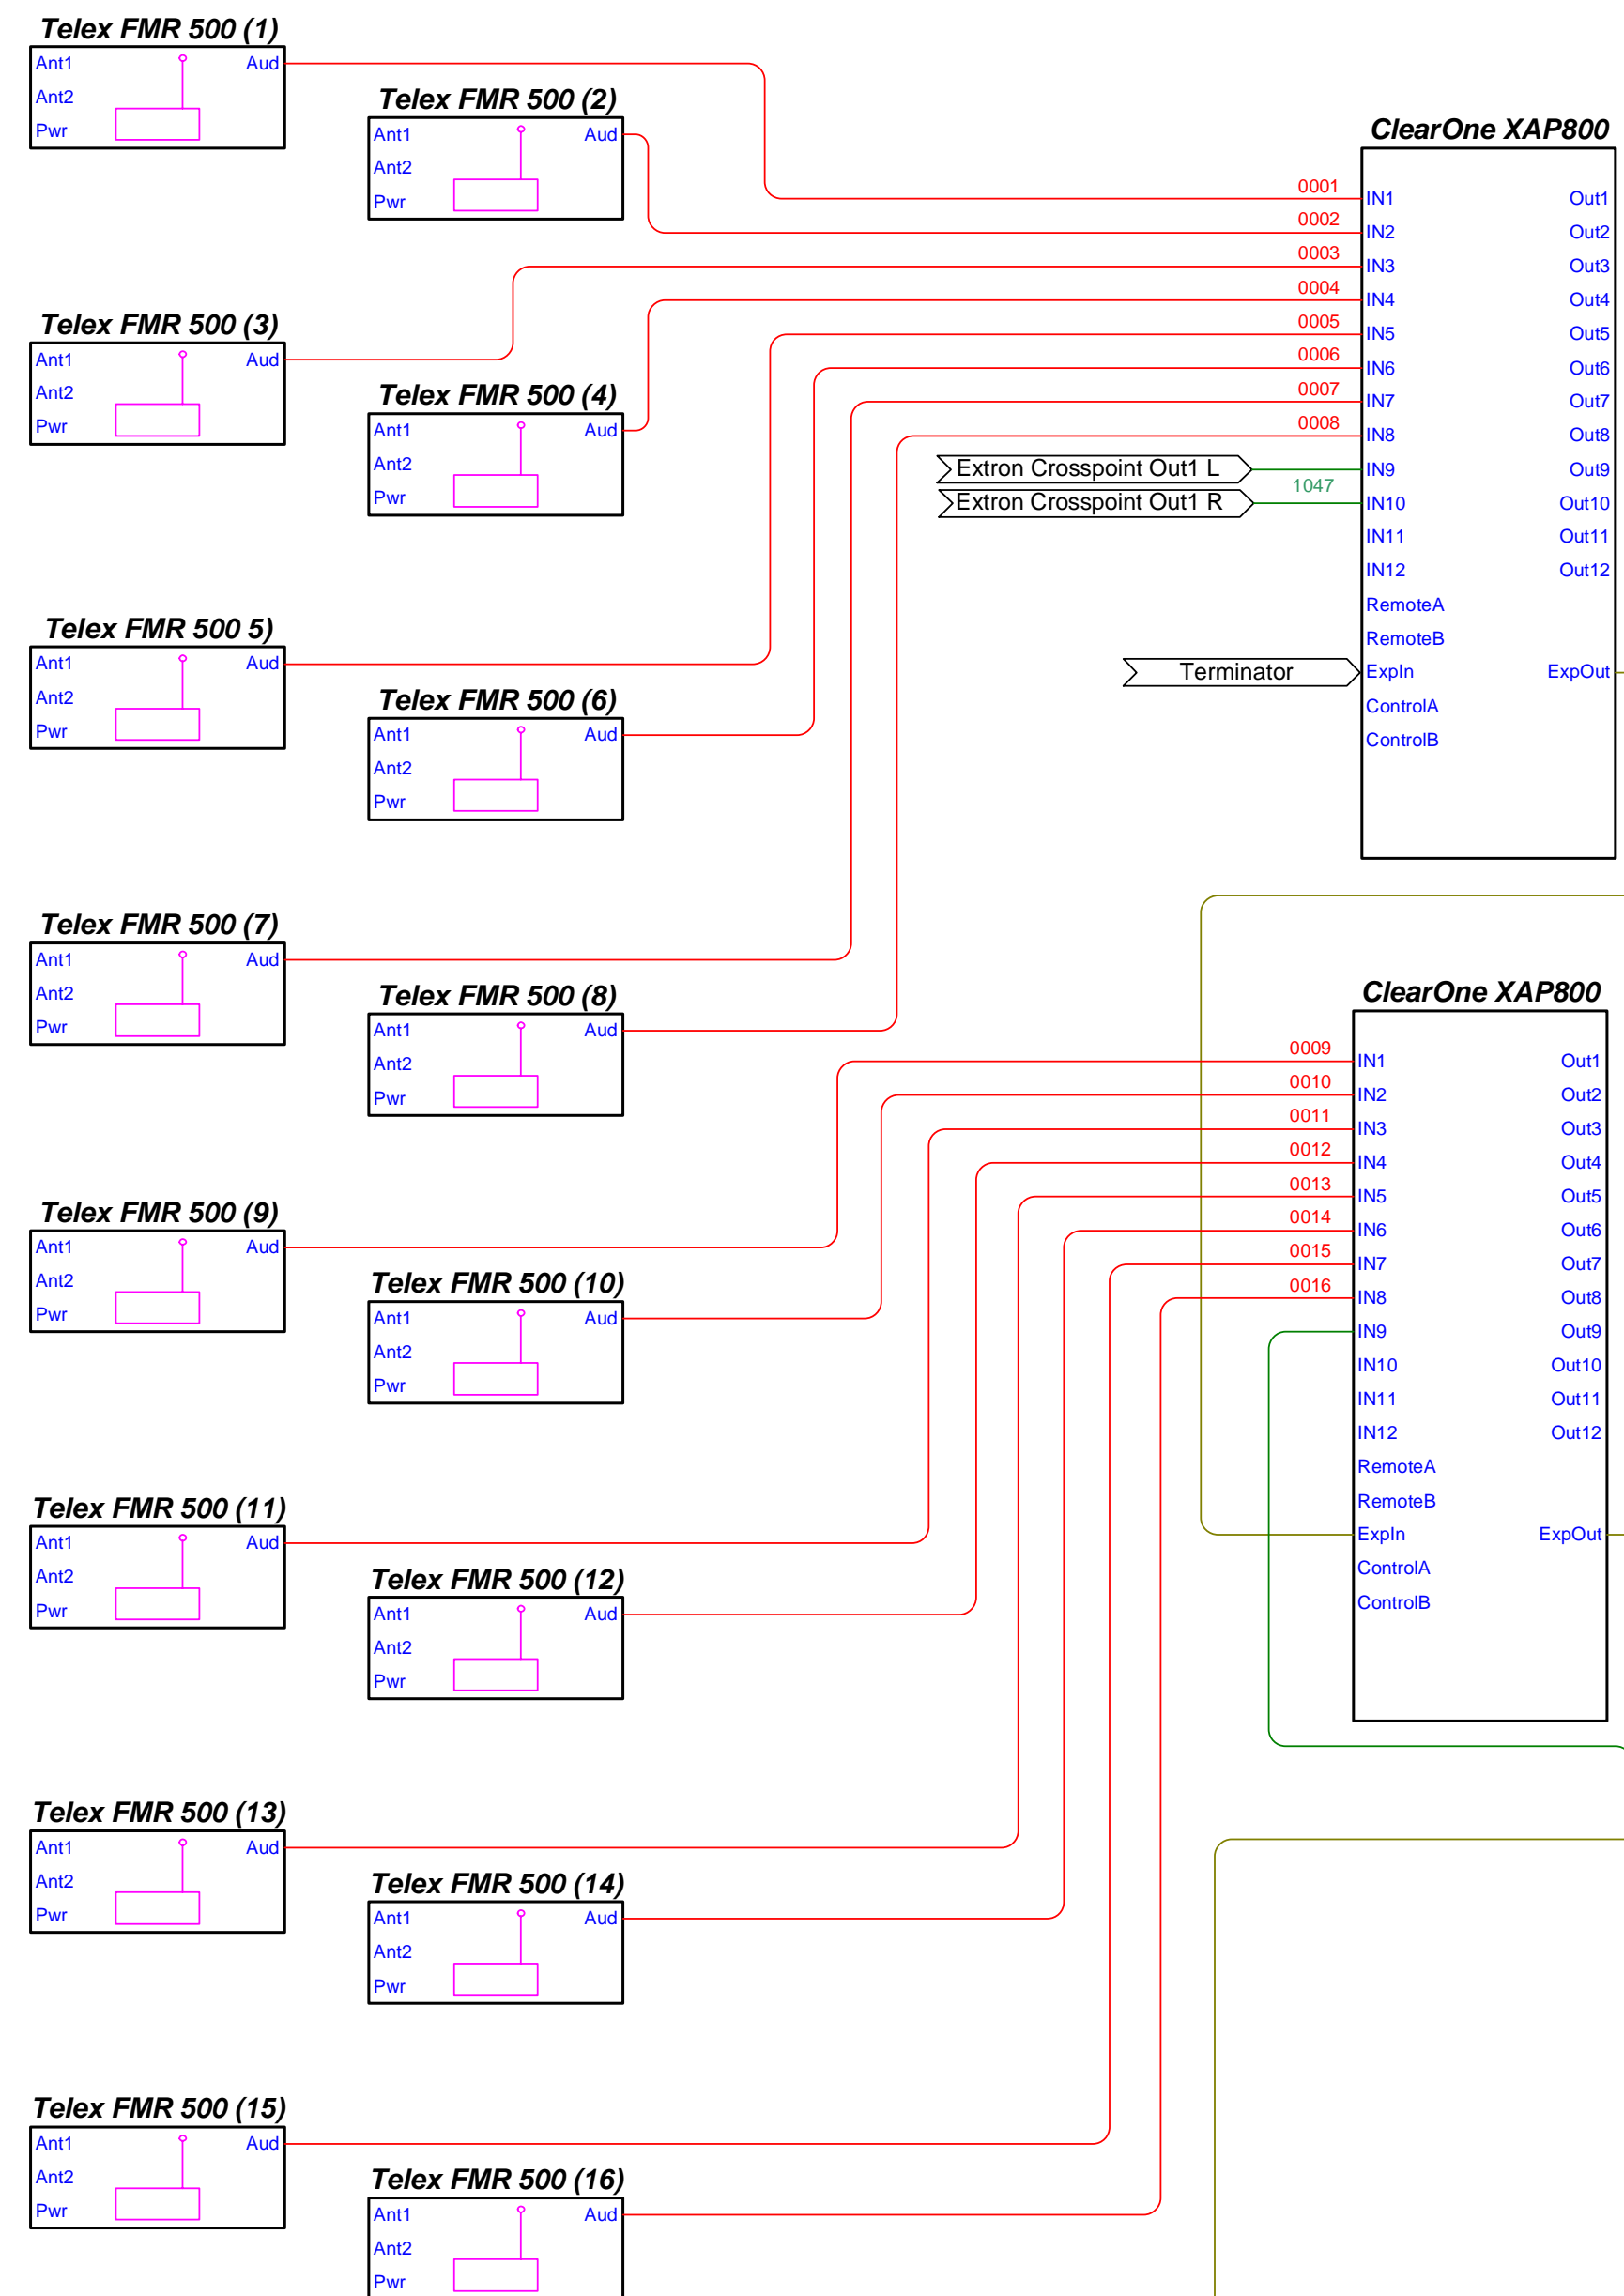



Typical of 14 Units  
Wireless Boundary  
Microphone  
Units 1-14

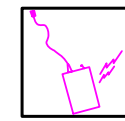

Typical of 2 Units  
Wireless Lapel  
Microphone  
Units 15-16

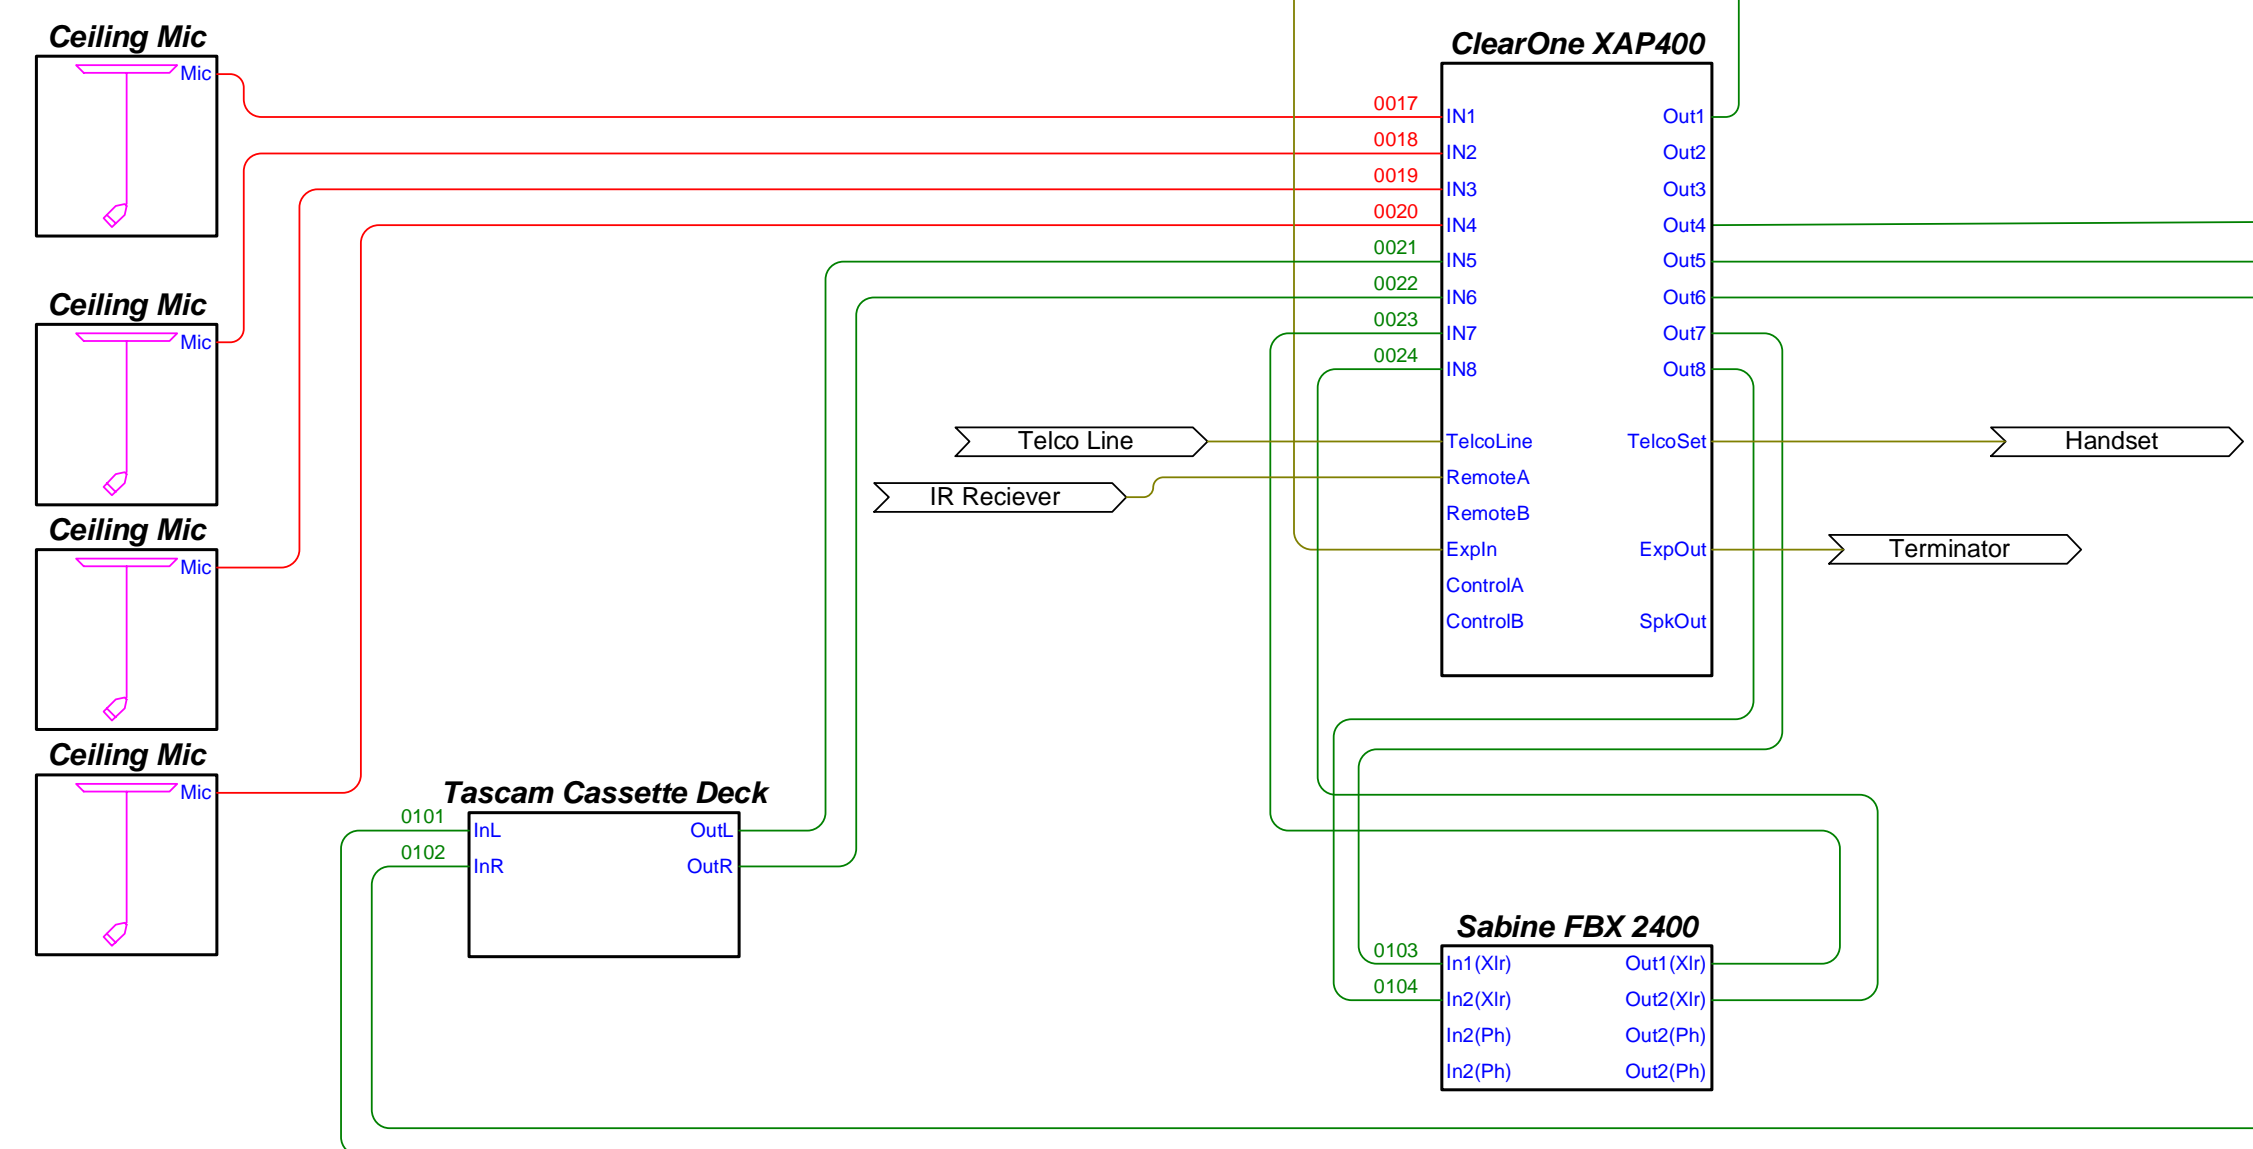

SIXTEEN RECEIVERS WITH FIVE SPLITTERS  
AND TWO ANTENNAS

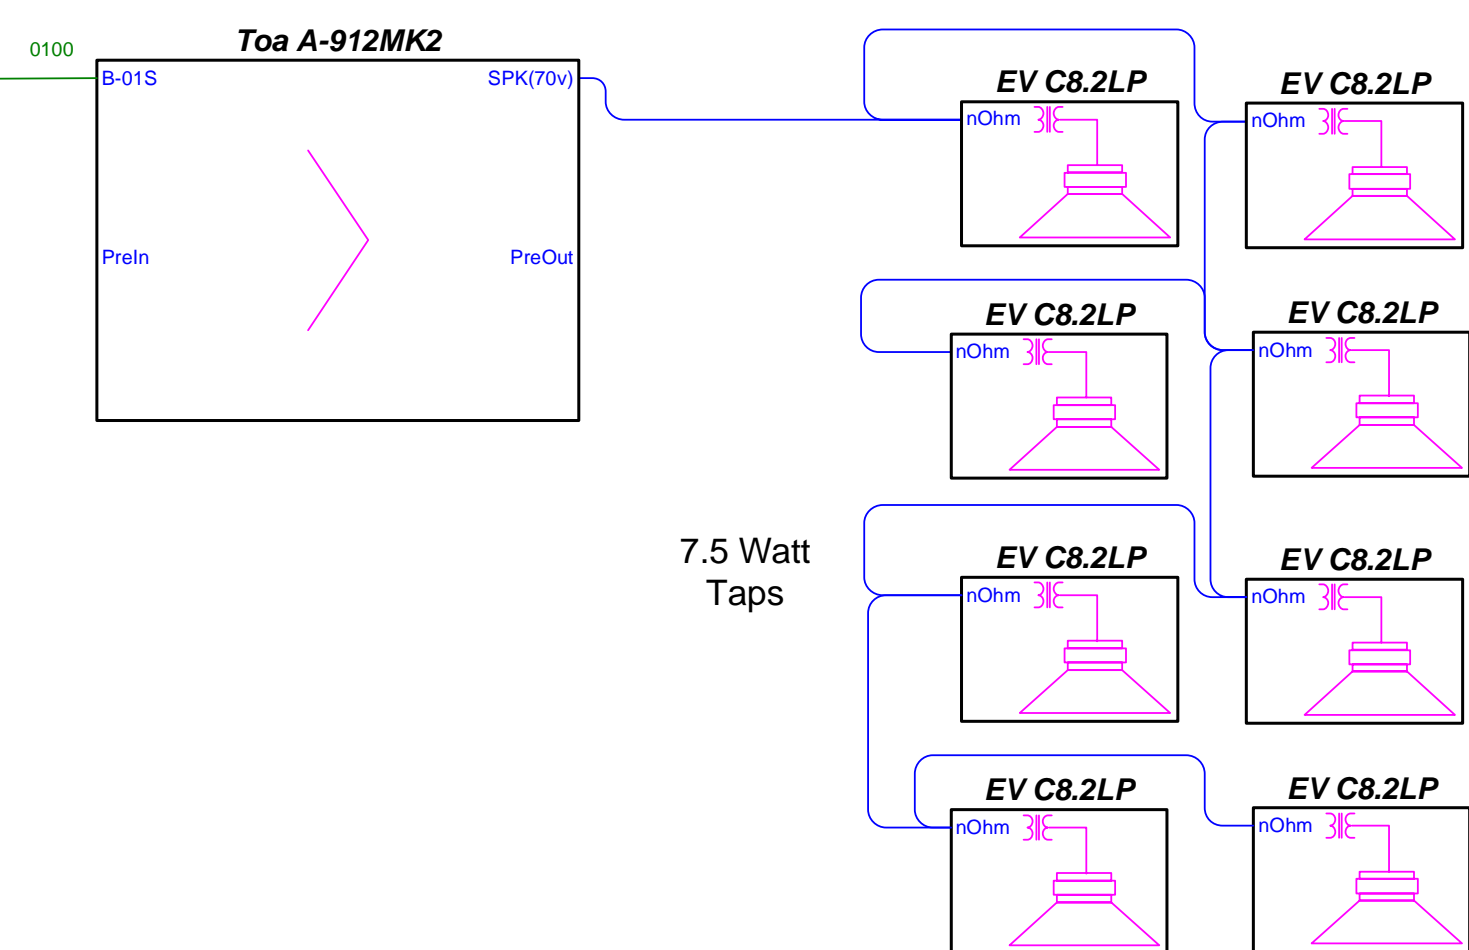

Wiring Index

Audio - Microphone	0000-0999
Audio - Line	1000-1999
Audio - Speaker	2000-2999
Control	3000-3999
Video - Composite/Svideo	4000-4999
Video - VGA/Component	5000-5999
Video - RF	6000-6999
Power	7000-7999
Fiber	8000-8999
Spare	9000-9999











Last Rev:	As-Built	08/02/07
Print Date:		11/14/07
Proj. Eng:		
Drawn By:		11/11/07

**FRONTIER MEDIA SOLUTIONS, LLC.**  
  
P.O. Box 634  
Springboro, Ohio 45066  
Tel: 937.704.9731 Fax: 937.704.0006  
www.frontiermediasolutions.com

CUSTOMER	
Christ Hospital	
PROJECT	
MA4538	
DWG TITLE	
Audio Block	
ma4538.vsd	DWG NUMBER
SCALE	MA4538
1.00 in.:1.00 in.	AV 01

Wiring Index

Audio - Microphone	0000-0999
Audio - Line	1000-1999
Audio - Speaker	2000-2999
Control	3000-3999
Video - Composite/Svideo	4000-4999
Video - VGA/Component	5000-5999
Video - RF	6000-6999
Power	7000-7999
Fiber - Category	8000-8999
Spare	9000-9999

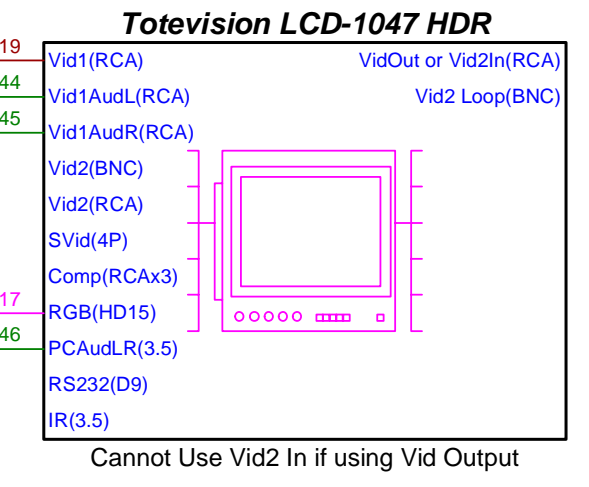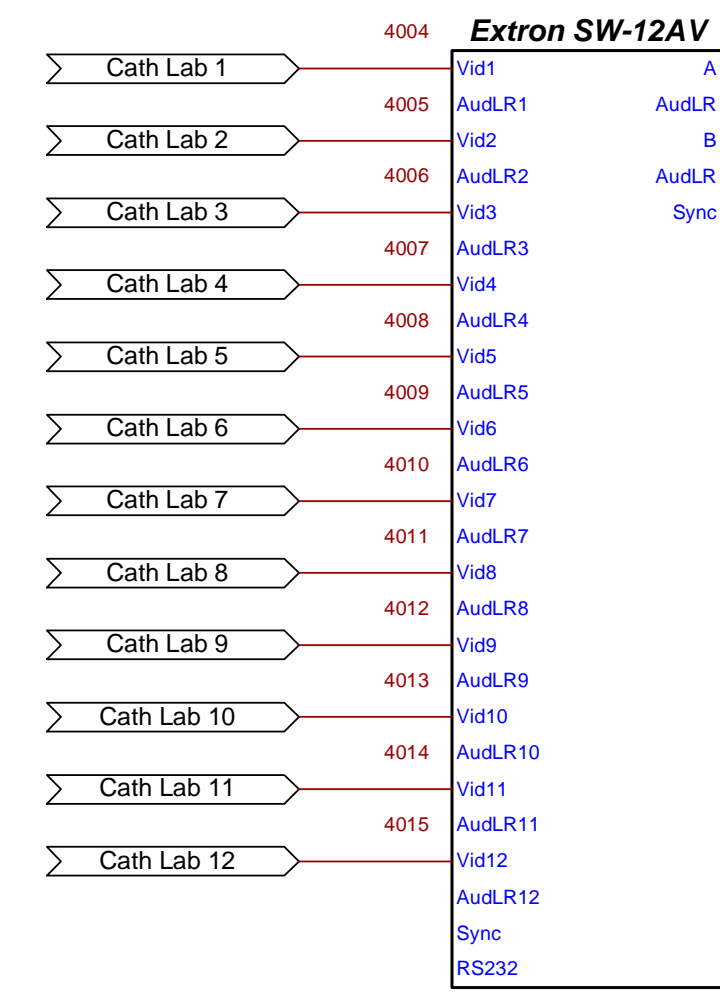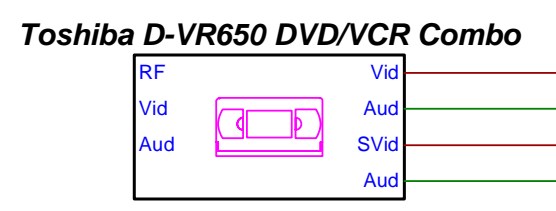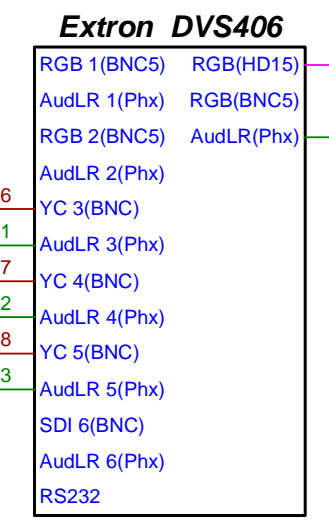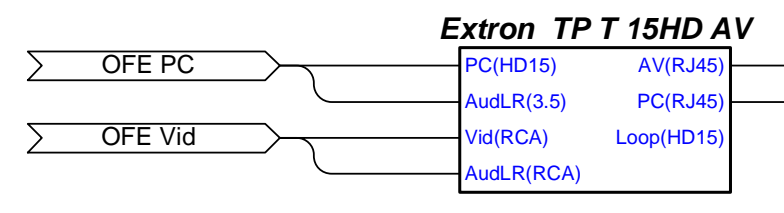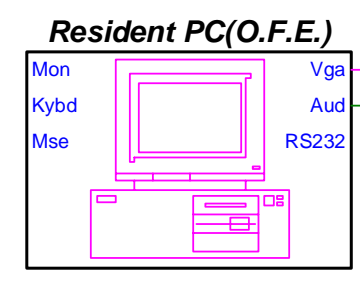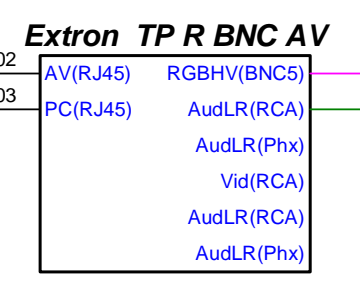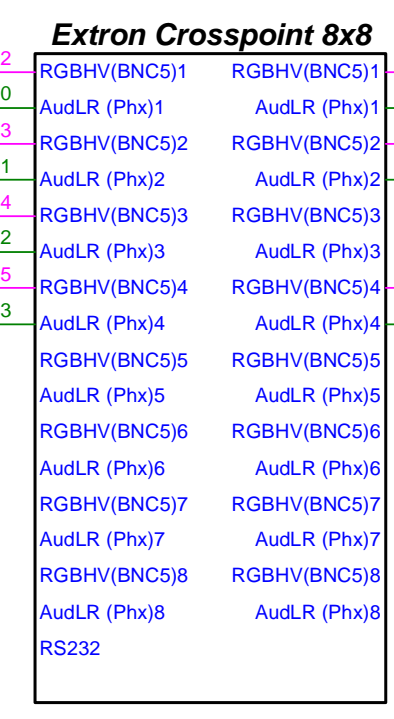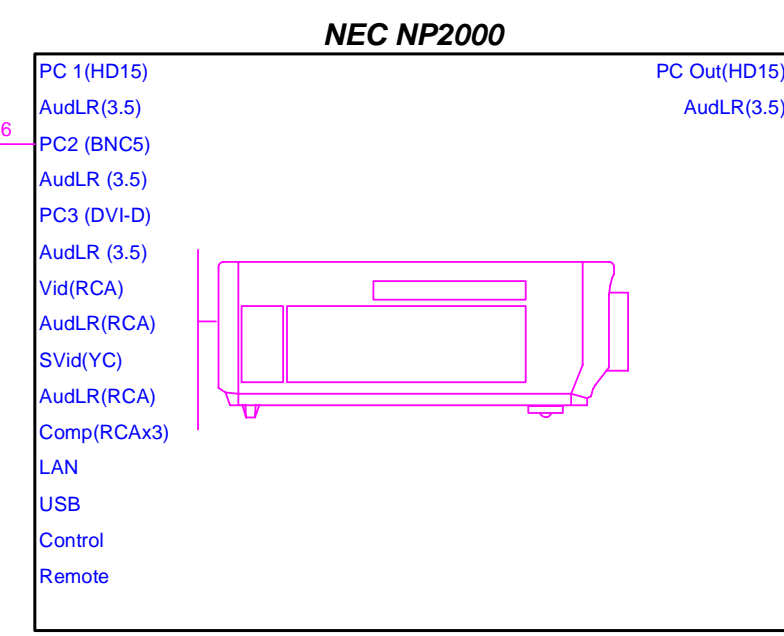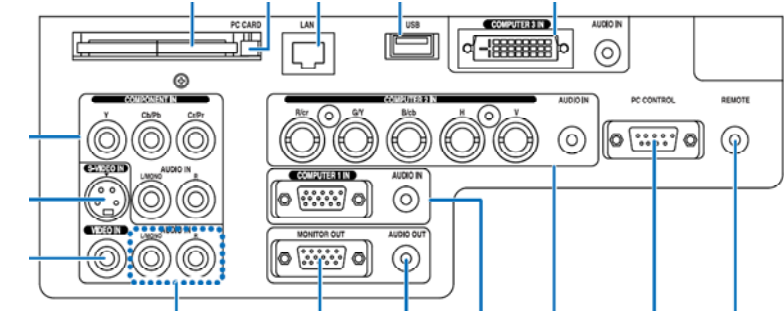


Last Rev:	As Built	08/02/07
Print Date:		11/14/07
Proj. Eng:		
Drawn By:		11/11/07

**FRONTIER**  
**MEDIA SOLUTIONS, LLC.**

P.O. Box 634  
Springboro, Ohio 45066  
Tel: 937.704.9731 Fax: 937.704.0006  
www.frontiermediasolutions.com

CUSTOMER	Christ Hospital
PROJECT	MA4538
DWG TITLE	Video Block
ma4538.vsd	DWG NUMBER MA4538
SCALE 1 ft.:1 ft.	AV 02

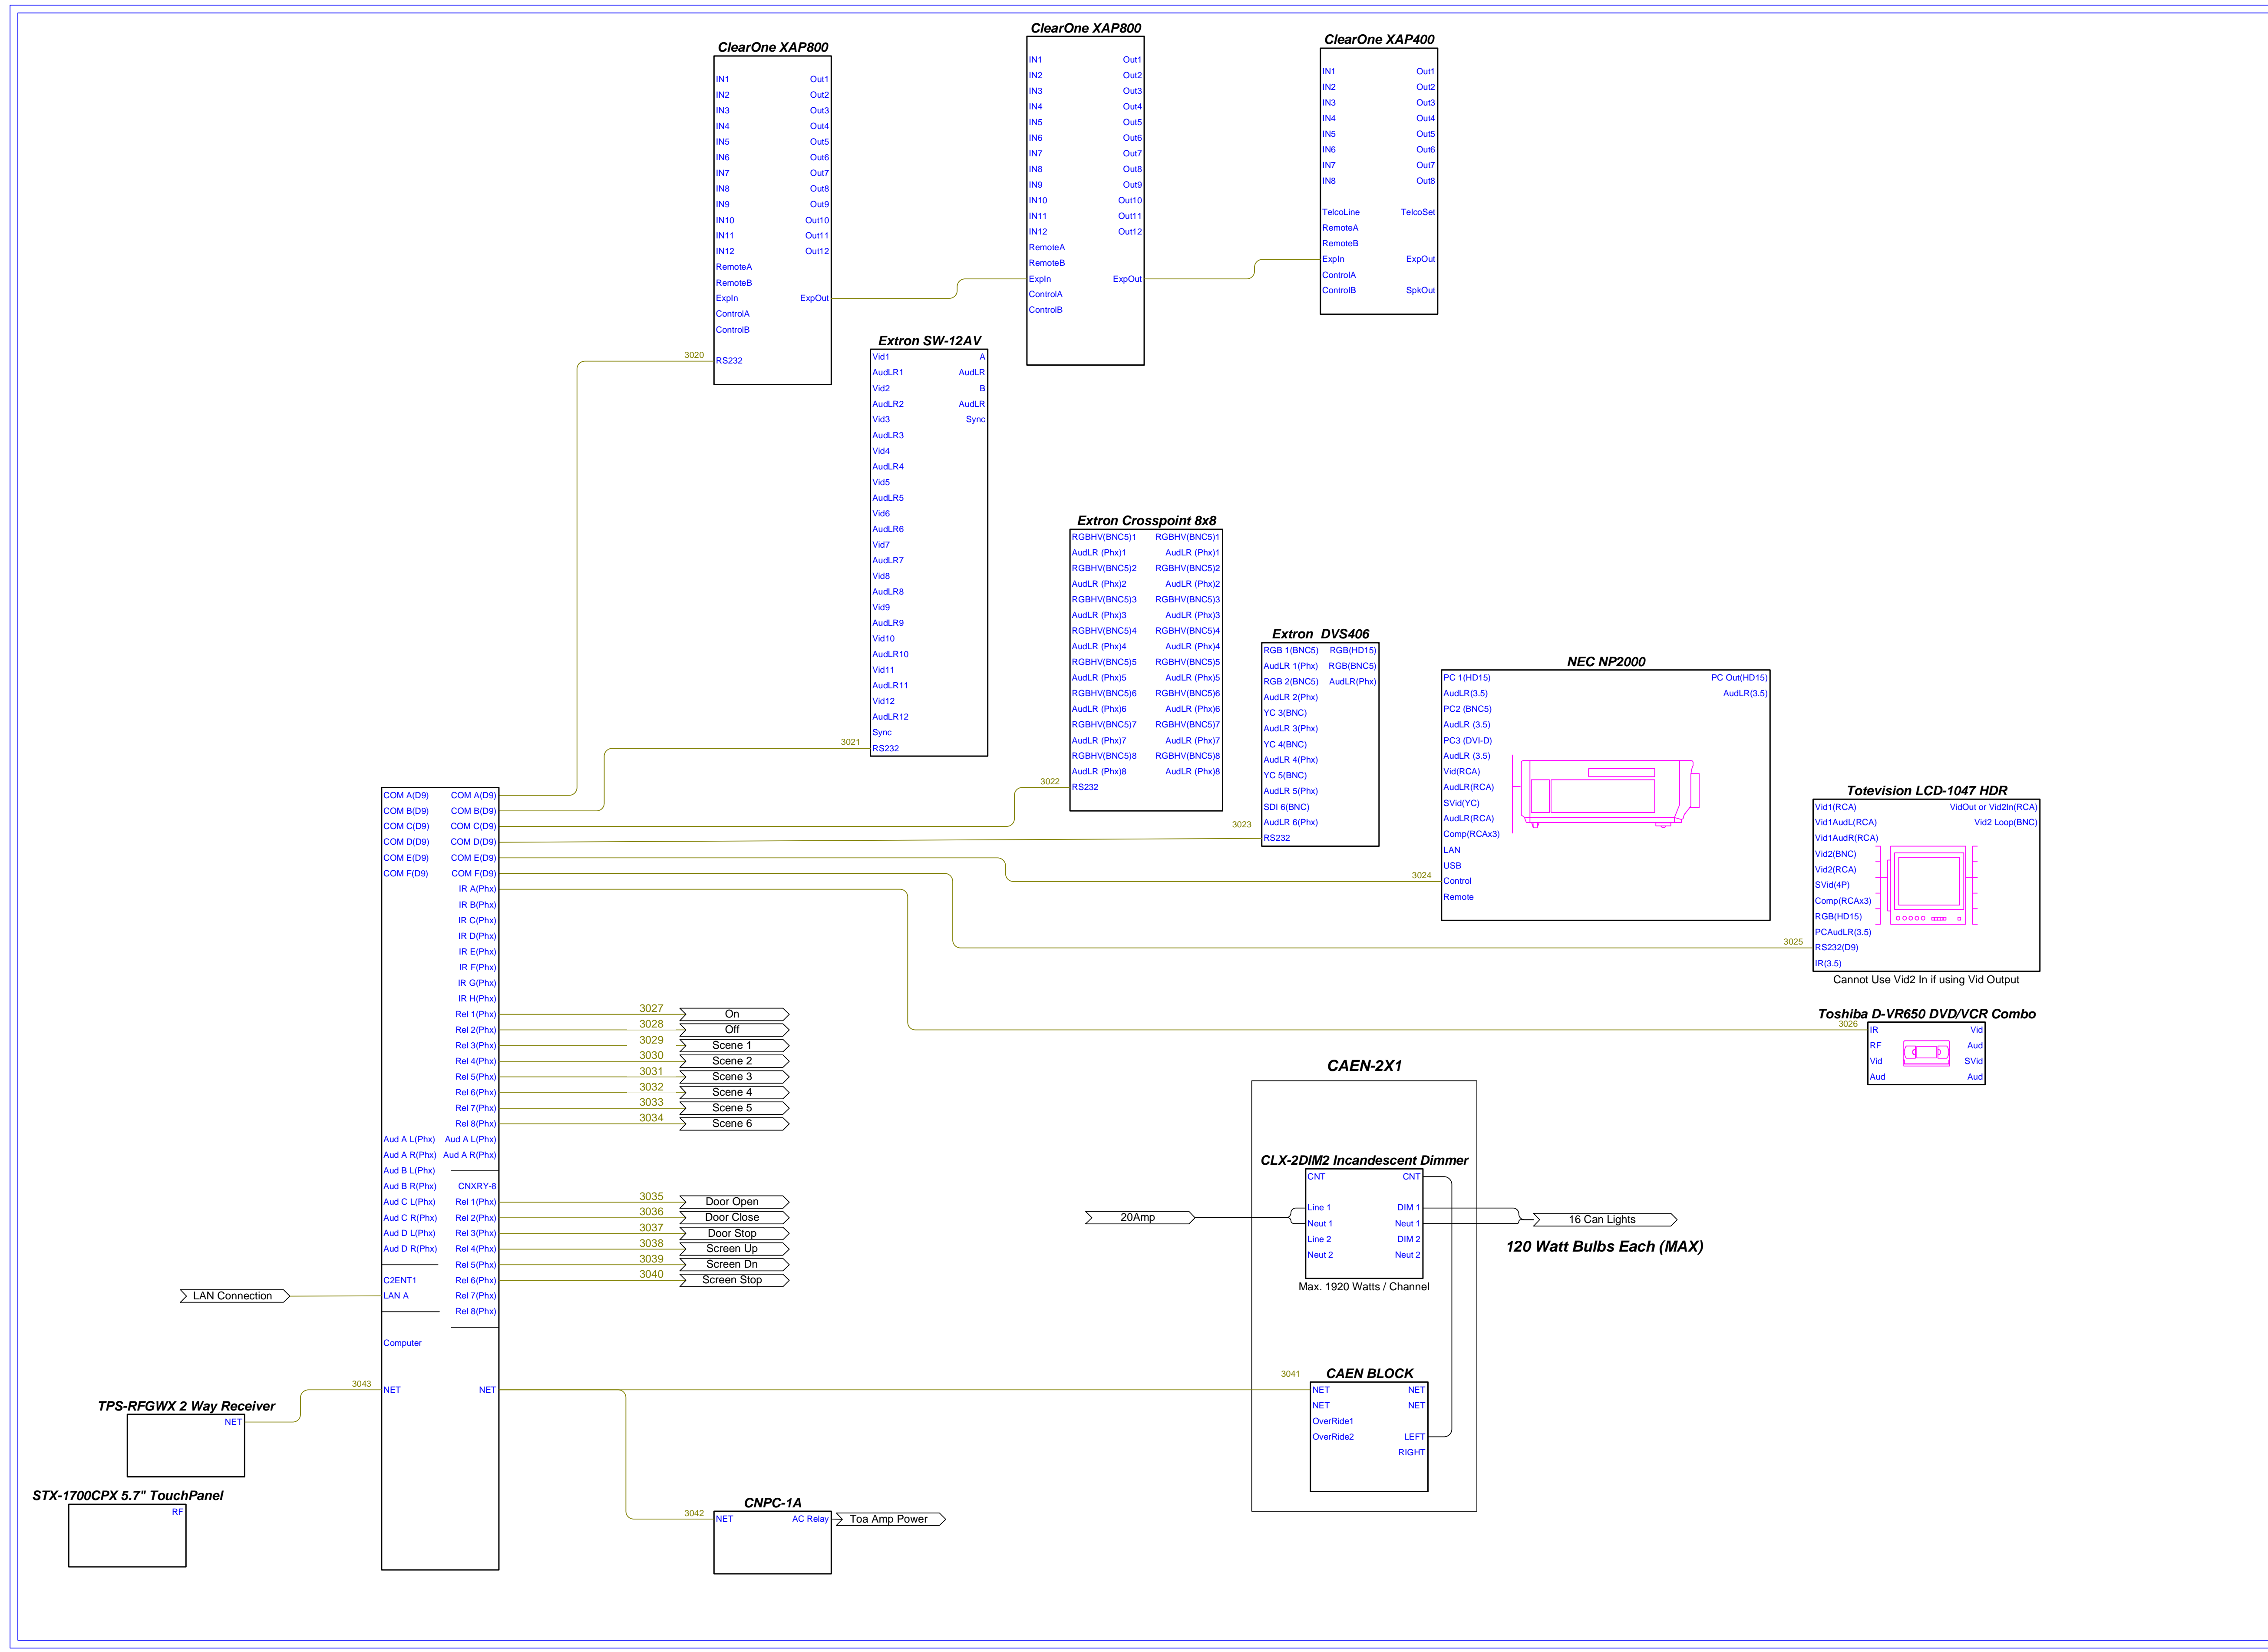

Wiring Index

Audio - Microphone	0000-0999
Audio - Line	1000-1999
Audio - Speaker	2000-2999
Control	3000-3999
Video - Composite/Svideo	4000-4999
Video - VGA/Component	5000-5999
Video - RF	6000-6999
Power	7000-7999
Fiber - Category	8000-8999
Spare	9000-9999


Last Rev:	As Built	08/02/07
Print Date:	11/14/07	
Proj. Eng:		
Drawn By:	11/11/07	

**FRONTIER**  
**MEDIA SOLUTIONS, LLC.**

P.O. Box 634  
Springboro, Ohio 45066  
Tel: 937.704.9731 Fax: 937.704.0006  
www.frontiermediasolutions.com


CUSTOMER	Christ Hospital
PROJECT	MA4538
DWG TITLE	Control Block
ma4538.vsd	DWG NUMBER MA4538
SCALE 1 ft.:1 ft.	AV 03

**FRONT**

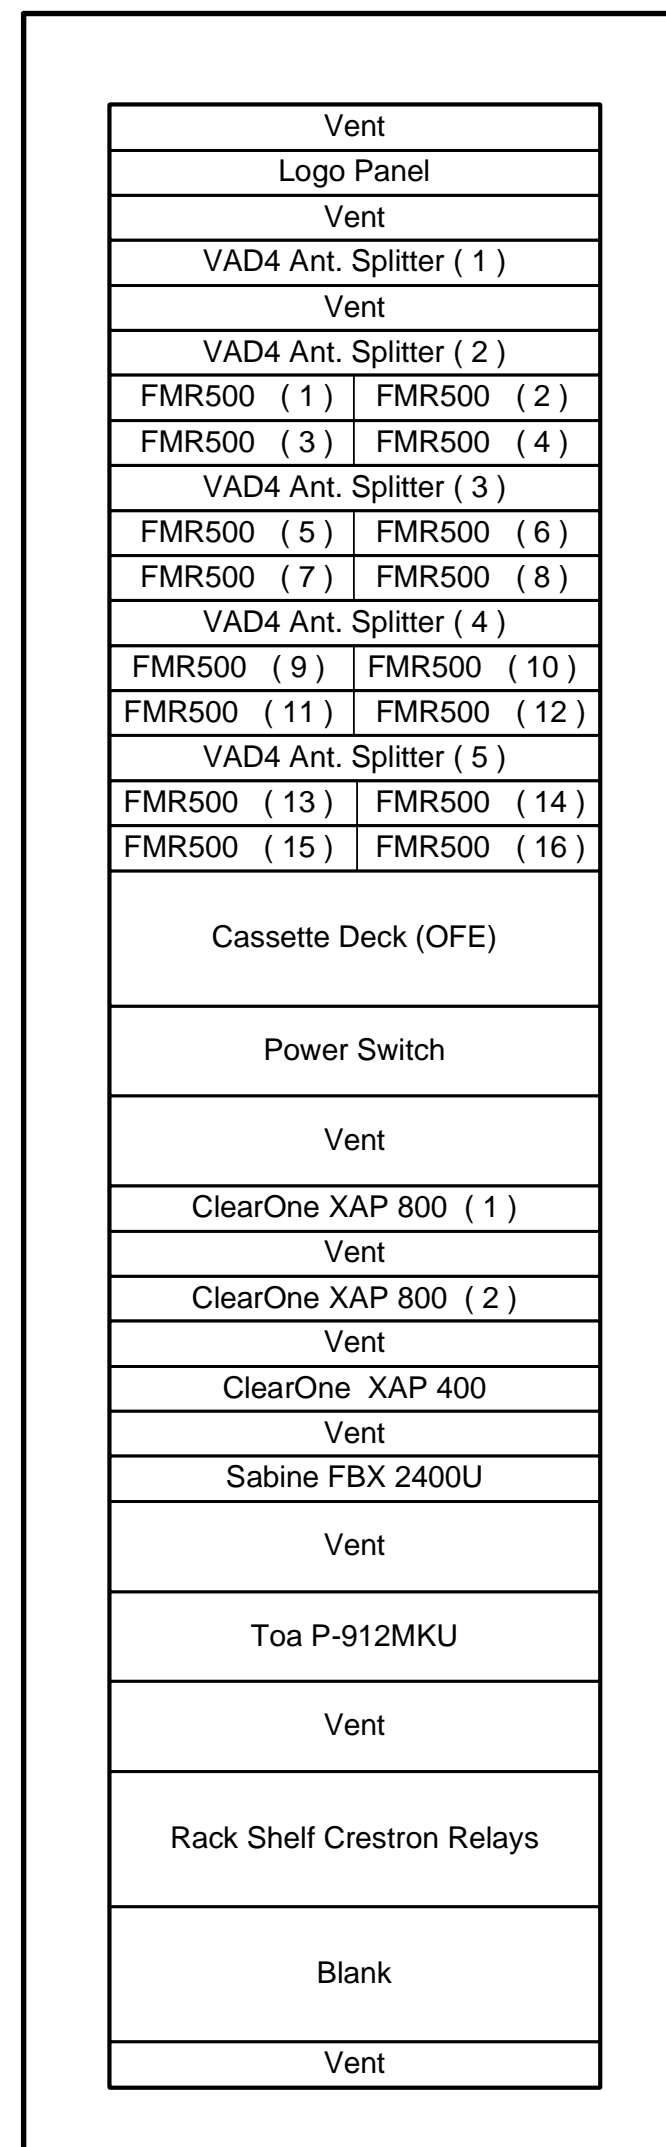


EqRack 1

**BACK**

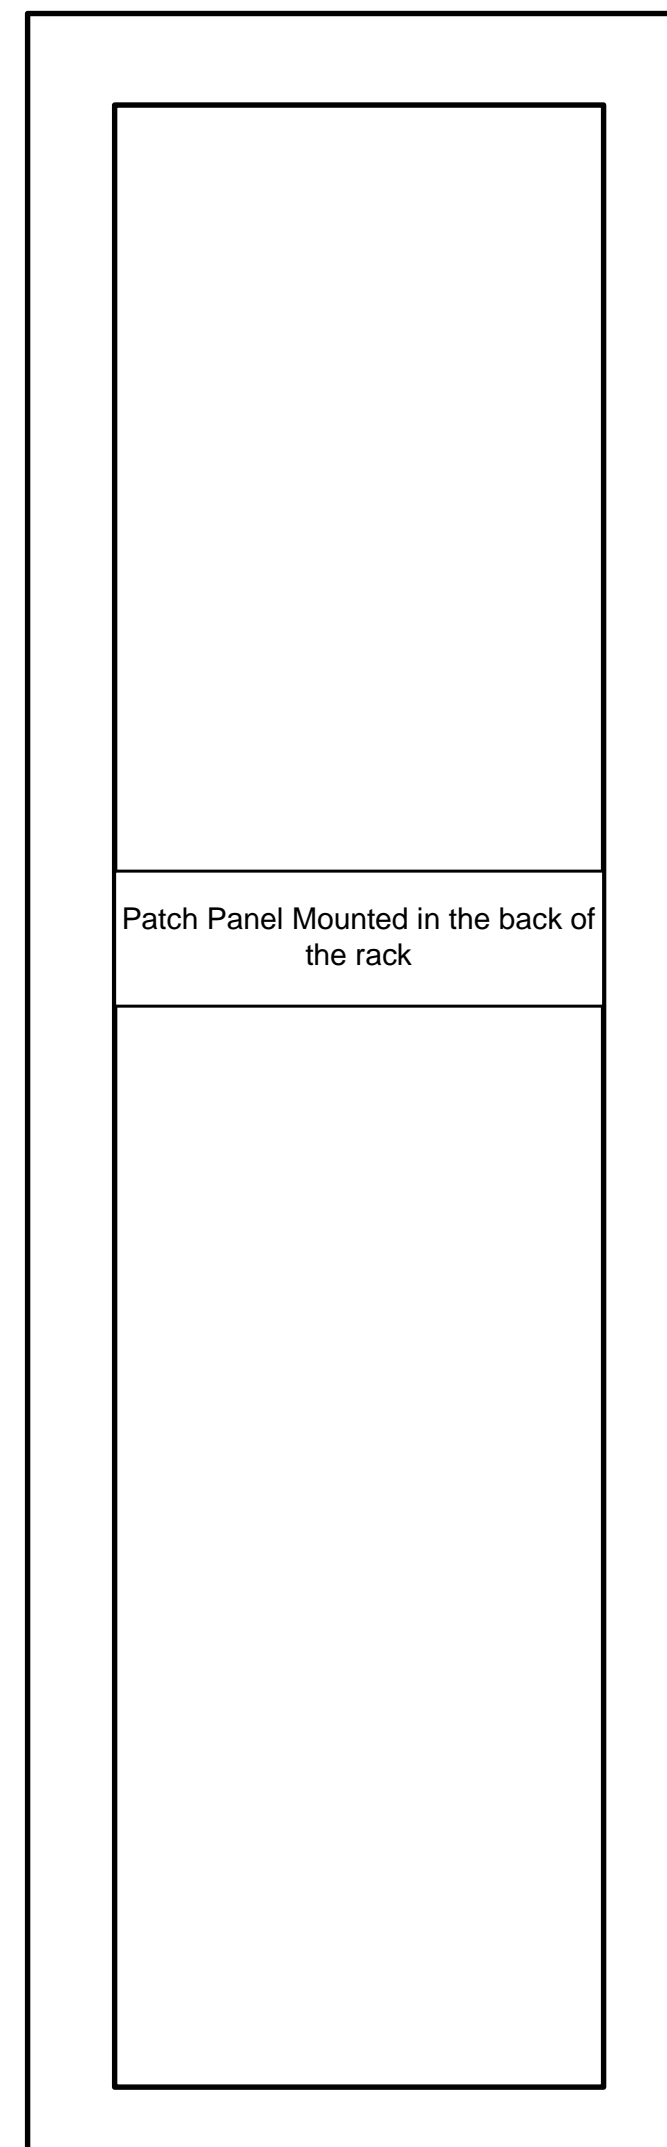


EqRack 1

**FRONT**

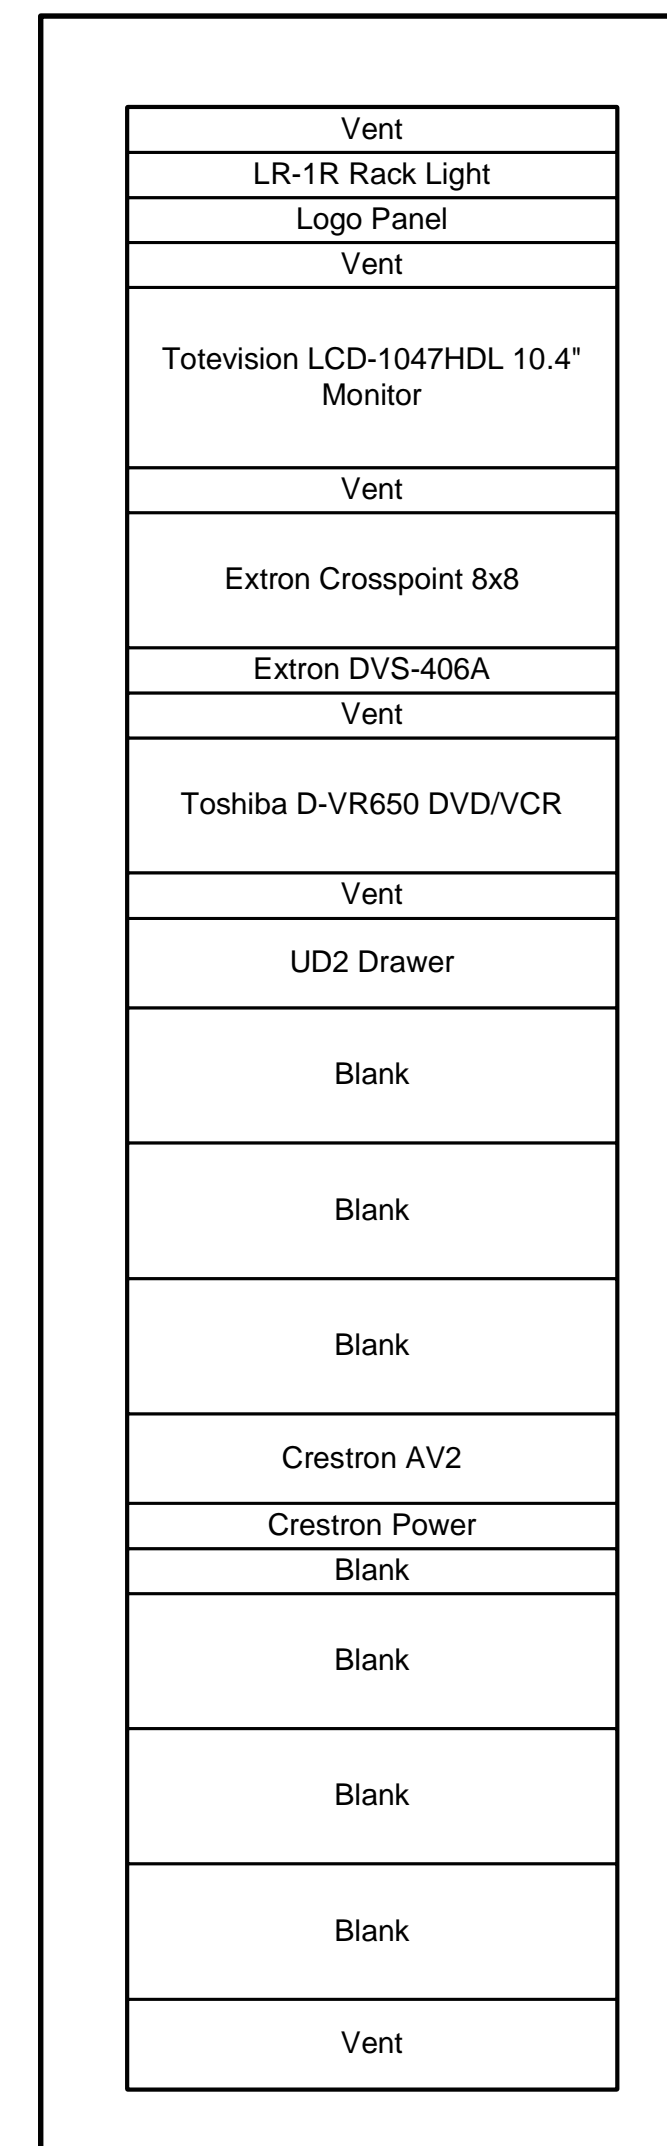

EqRack 2

**BACK**

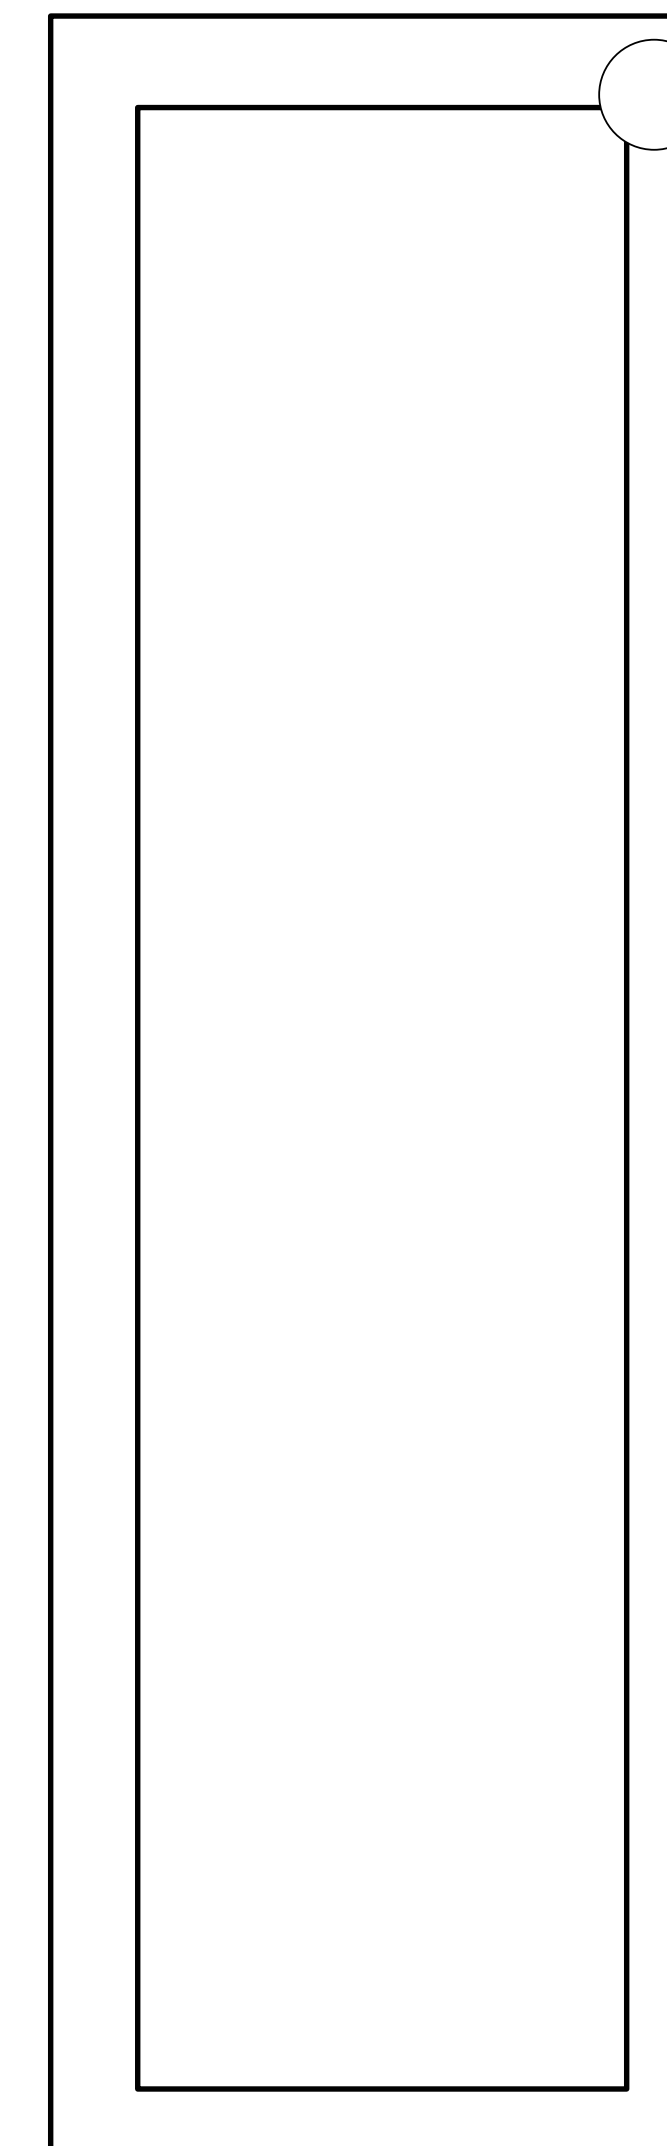

EqRack 2

Wiring Index

Audio - Microphone	0000-0999
Audio - Line	1000-1999
Audio - Speaker	2000-2999
Control	3000-3999
Video - Composite/Svideo	4000-4999
Video - VGA/Component	5000-5999
Video - RF	6000-6999
Power	7000-7999
Fiber - Category	8000-8999
Spare	9000-9999

Last Rev:	As Built	08/02/07
Print Date:		11/14/07
Proj. Eng:		
Drawn By:		11/11/07



P.O. Box 634  
Springboro, Ohio 45066  
Tel: 937.704.9731 Fax: 937.704.0006  
[www.frontiermediasolutions.com](http://www.frontiermediasolutions.com)

CUSTOMER	Christ Hosptial
PROJECT	MA4538
DWG TITLE	Rack Layouts
ma4538.vsd	DWG NUMBER MA4538
SCALE 1 ft.:1 ft.	AV 04